





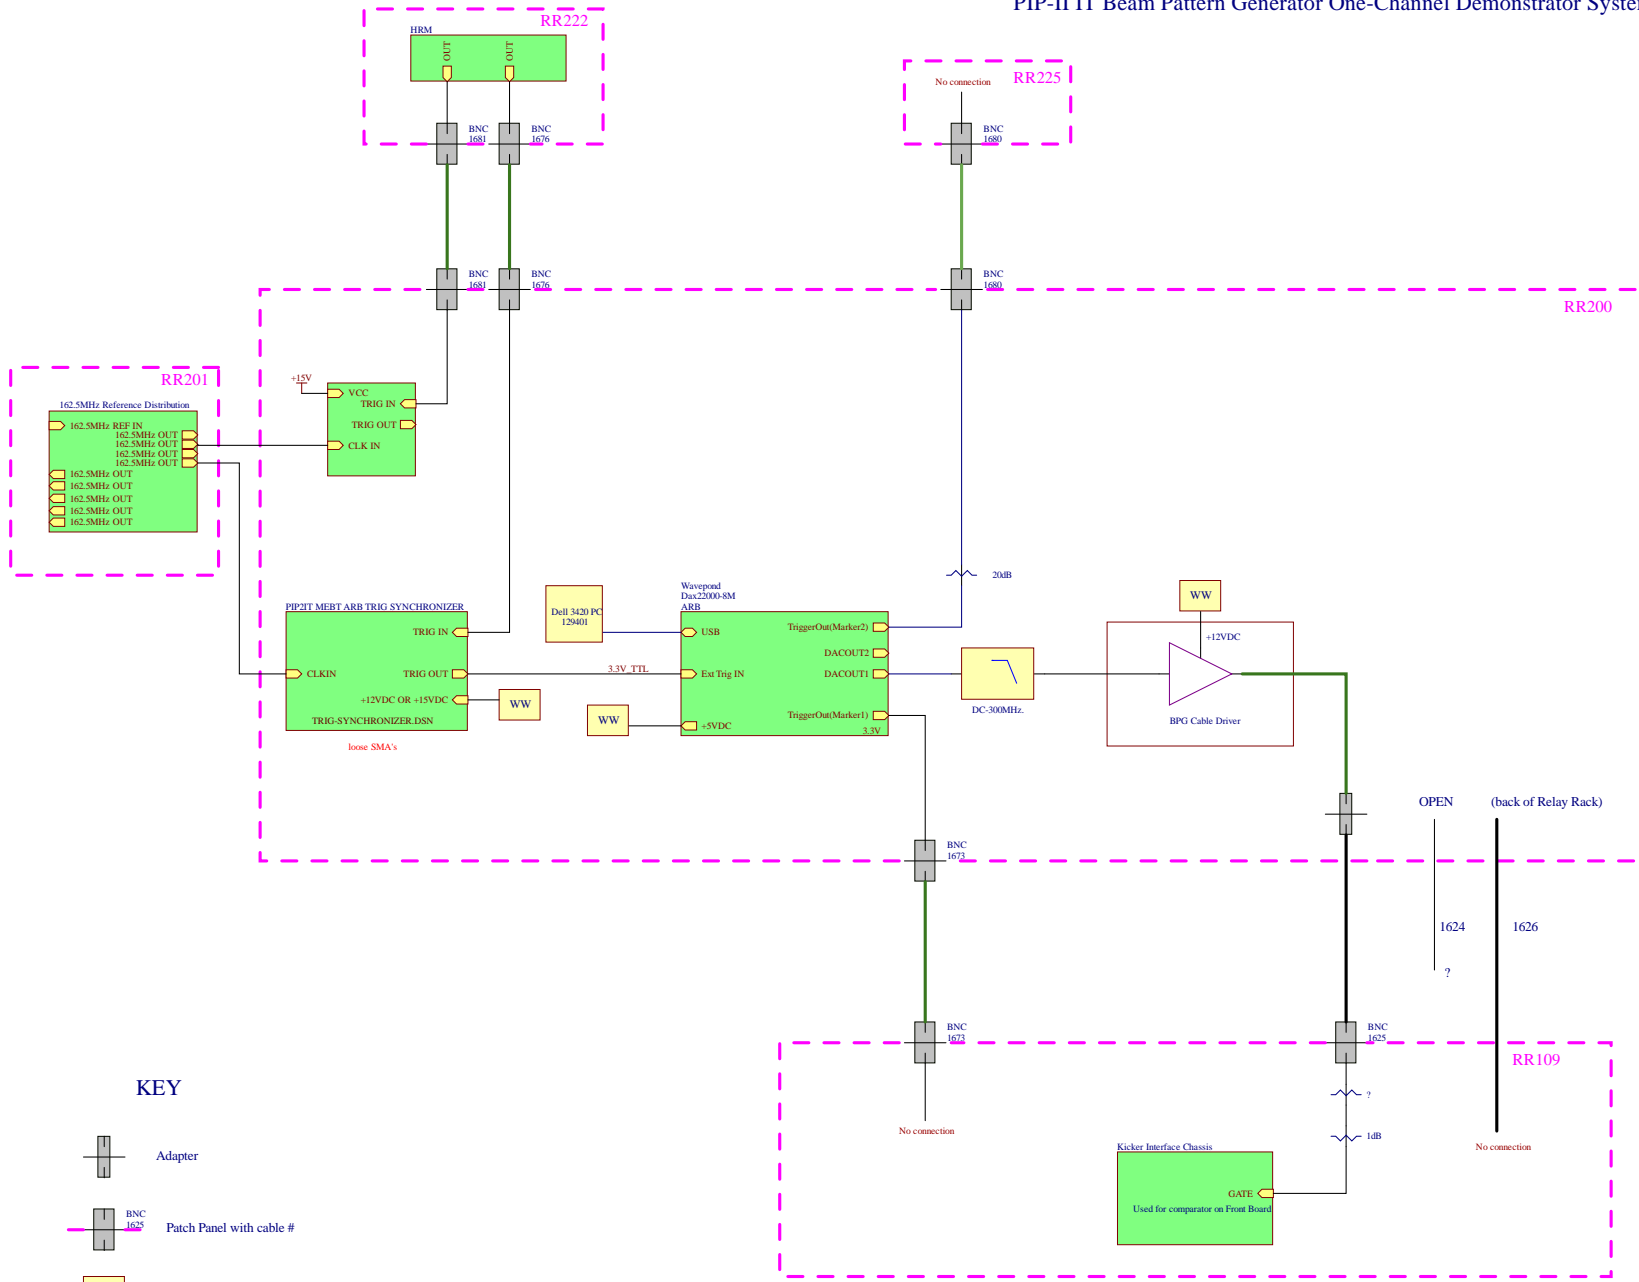


PIP-II IT Beam Pattern Generator One-Channel Demonstrator System, As-Installed configuration

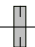

KEY

-  Adapter
-  BNC 1625 Patch Panel with cable #
-  Wall Wart AC Adapter
-  RG58
-  1/2" HELIAX

		Operated by Fermi Research Alliance, LLC under Contract No. DE-AC02-07CH11399 with the United States Department of Energy.	
Size: C	Rev: *	ENGINEER: *	DRAWN: Dan Klepec
Number: *	Date: 3/26/2020	CHECKED: *	APPROVED: *
	Time: 2:40:31 PM	Sheet: *	of: *